

PLAN NOTES:

- AS-BUILT INFORMATION WAS A RESULT OF A FIELD SURVEY BY BORDERLAND ENGINEERING, INC. IN AUGUST, 2017.
- BURIED UTILITY LOCATIONS ARE APPROXIMATE ONLY. FIELD VERIFY ALL UTILITIES PRIOR TO DEMOLITION/CONSTRUCTION. CALL DIG-SAFE AT 1-888-DIG-SAFE.

LAND SURVEYOR:
 BORDERLAND ENGINEERING, INC.
 61b PLEASANT STREET
 RANDOLPH, MA 02368

I CERTIFY THAT THIS PLAN HAS BEEN PREPARED IN CONFORMITY WITH THE RULES AND REGULATIONS OF THE REGISTERS OF DEEDS OF THE COMMONWEALTH OF MASSACHUSETTS.

DATE: _____

REGISTERED LAND SURVEYOR

I CERTIFY THAT THIS PLAN SHOWS THE PROPERTY LINES THAT ARE THE LINES OF EXISTING OWNERSHIPS, AND THE LINES OF STREETS AND WAYS SHOWN ARE THOSE OF PUBLIC OR PRIVATE STREETS OR WAYS ALREADY ESTABLISHED, AND THAT NO NEW LINES FOR DIVISION OF EXISTING OWNERSHIP OR FOR NEW WAYS ARE SHOWN.

DATE: _____

REGISTERED LAND SURVEYOR

DATE APPROVED: _____

PLANNING BOARD - TOWN OF WESTWOOD

DATE APPROVED: _____

BOARD OF SELECTMAN - TOWN OF WESTWOOD

RECEIVED AND FILED: _____

WESTWOOD TOWN CLERK


STREET ACCEPTANCE &
 AS-BUILT PLAN
 THOMPSON AVENUE
 IN
 WESTWOOD, MA
 SCALE: AS SHOWN AUG. 30, 2017
 Site Design Professionals, LLC

Civil Engineers
 One Merchant Street - Suite 110
 Sharon, MA 02067
 Tel. 781-784-4020 - Fax 781-784-4022

REVISIONS	
01	OC.T. 13, 2017




- PROJECT BENCHMARK No. 1:**
 TOP HYDRANT SPINDLE
 ELEV.=190.10
- PROJECT BENCHMARK No. 2:**
 TOP HYDRANT SPINDLE
 ELEV.=191.26
- PROJECT BENCHMARK No. 3:**
 TOP HYDRANT SPINDLE
 ELEV.=196.17

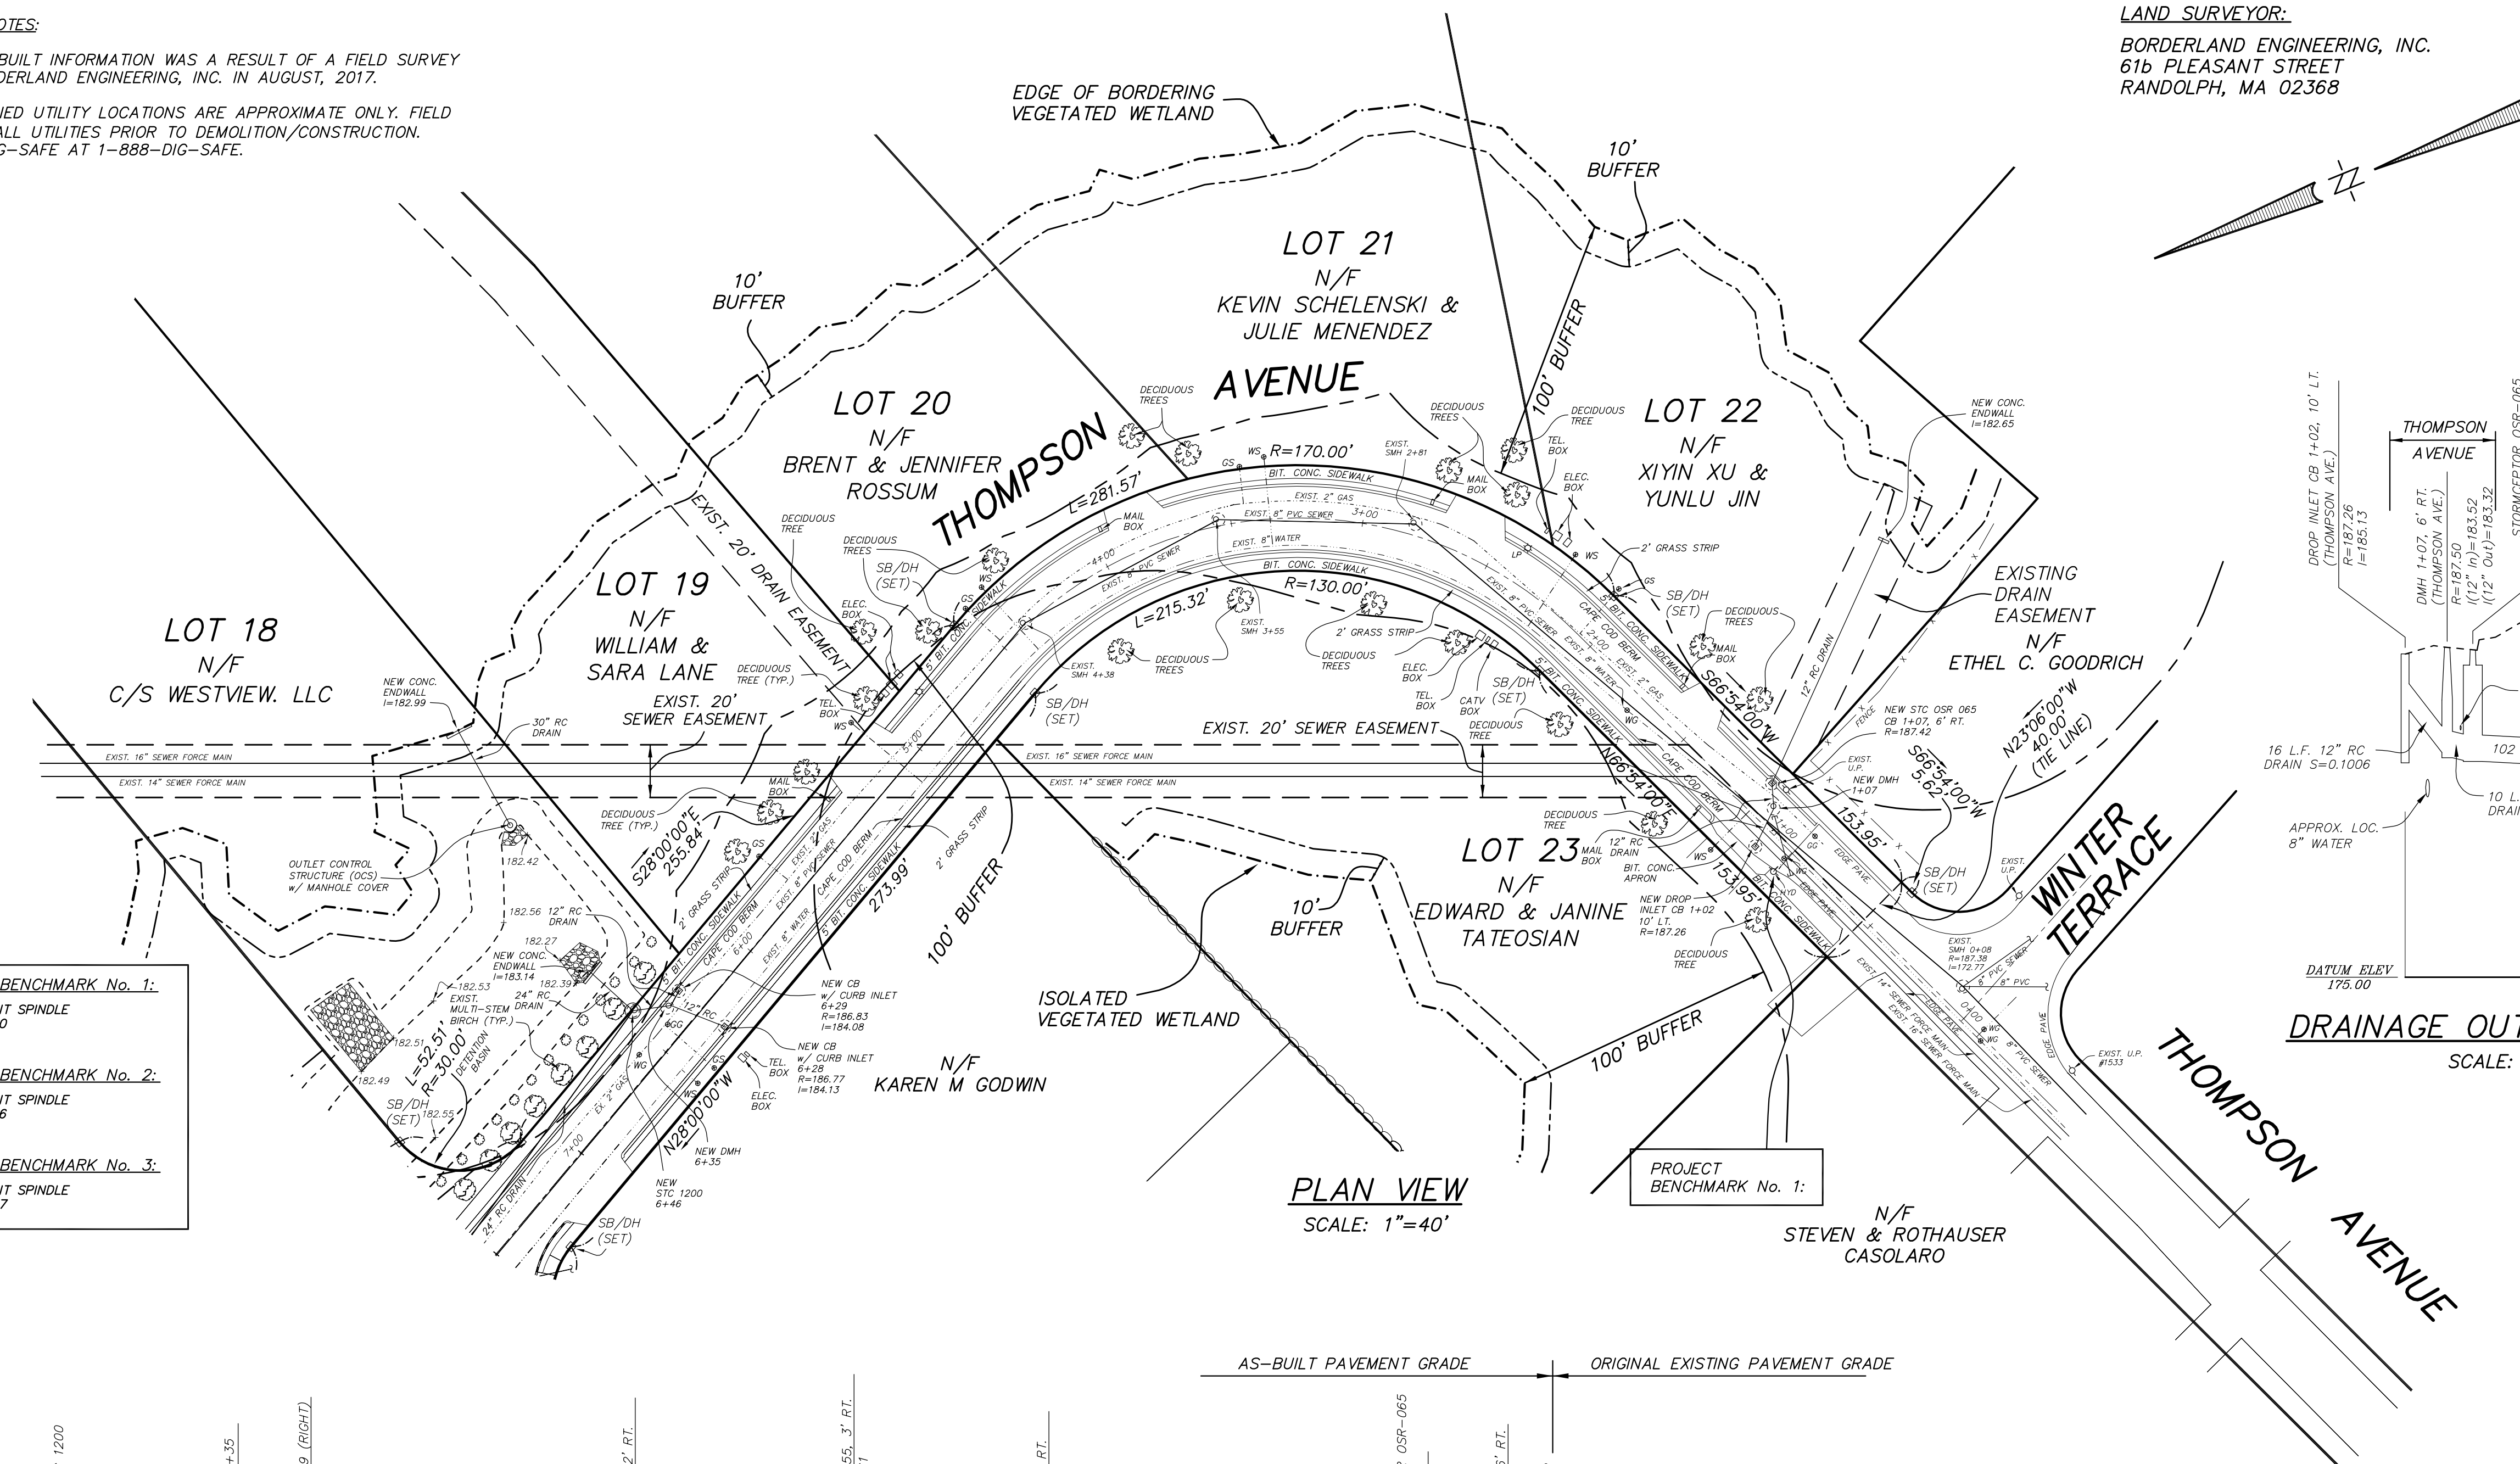

PLAN VIEW
 SCALE: 1"=40'

DRAINAGE OUTLET PROFILE No. 1
 SCALE: 1"=40' HORIZ.
 1"=4' VERT.

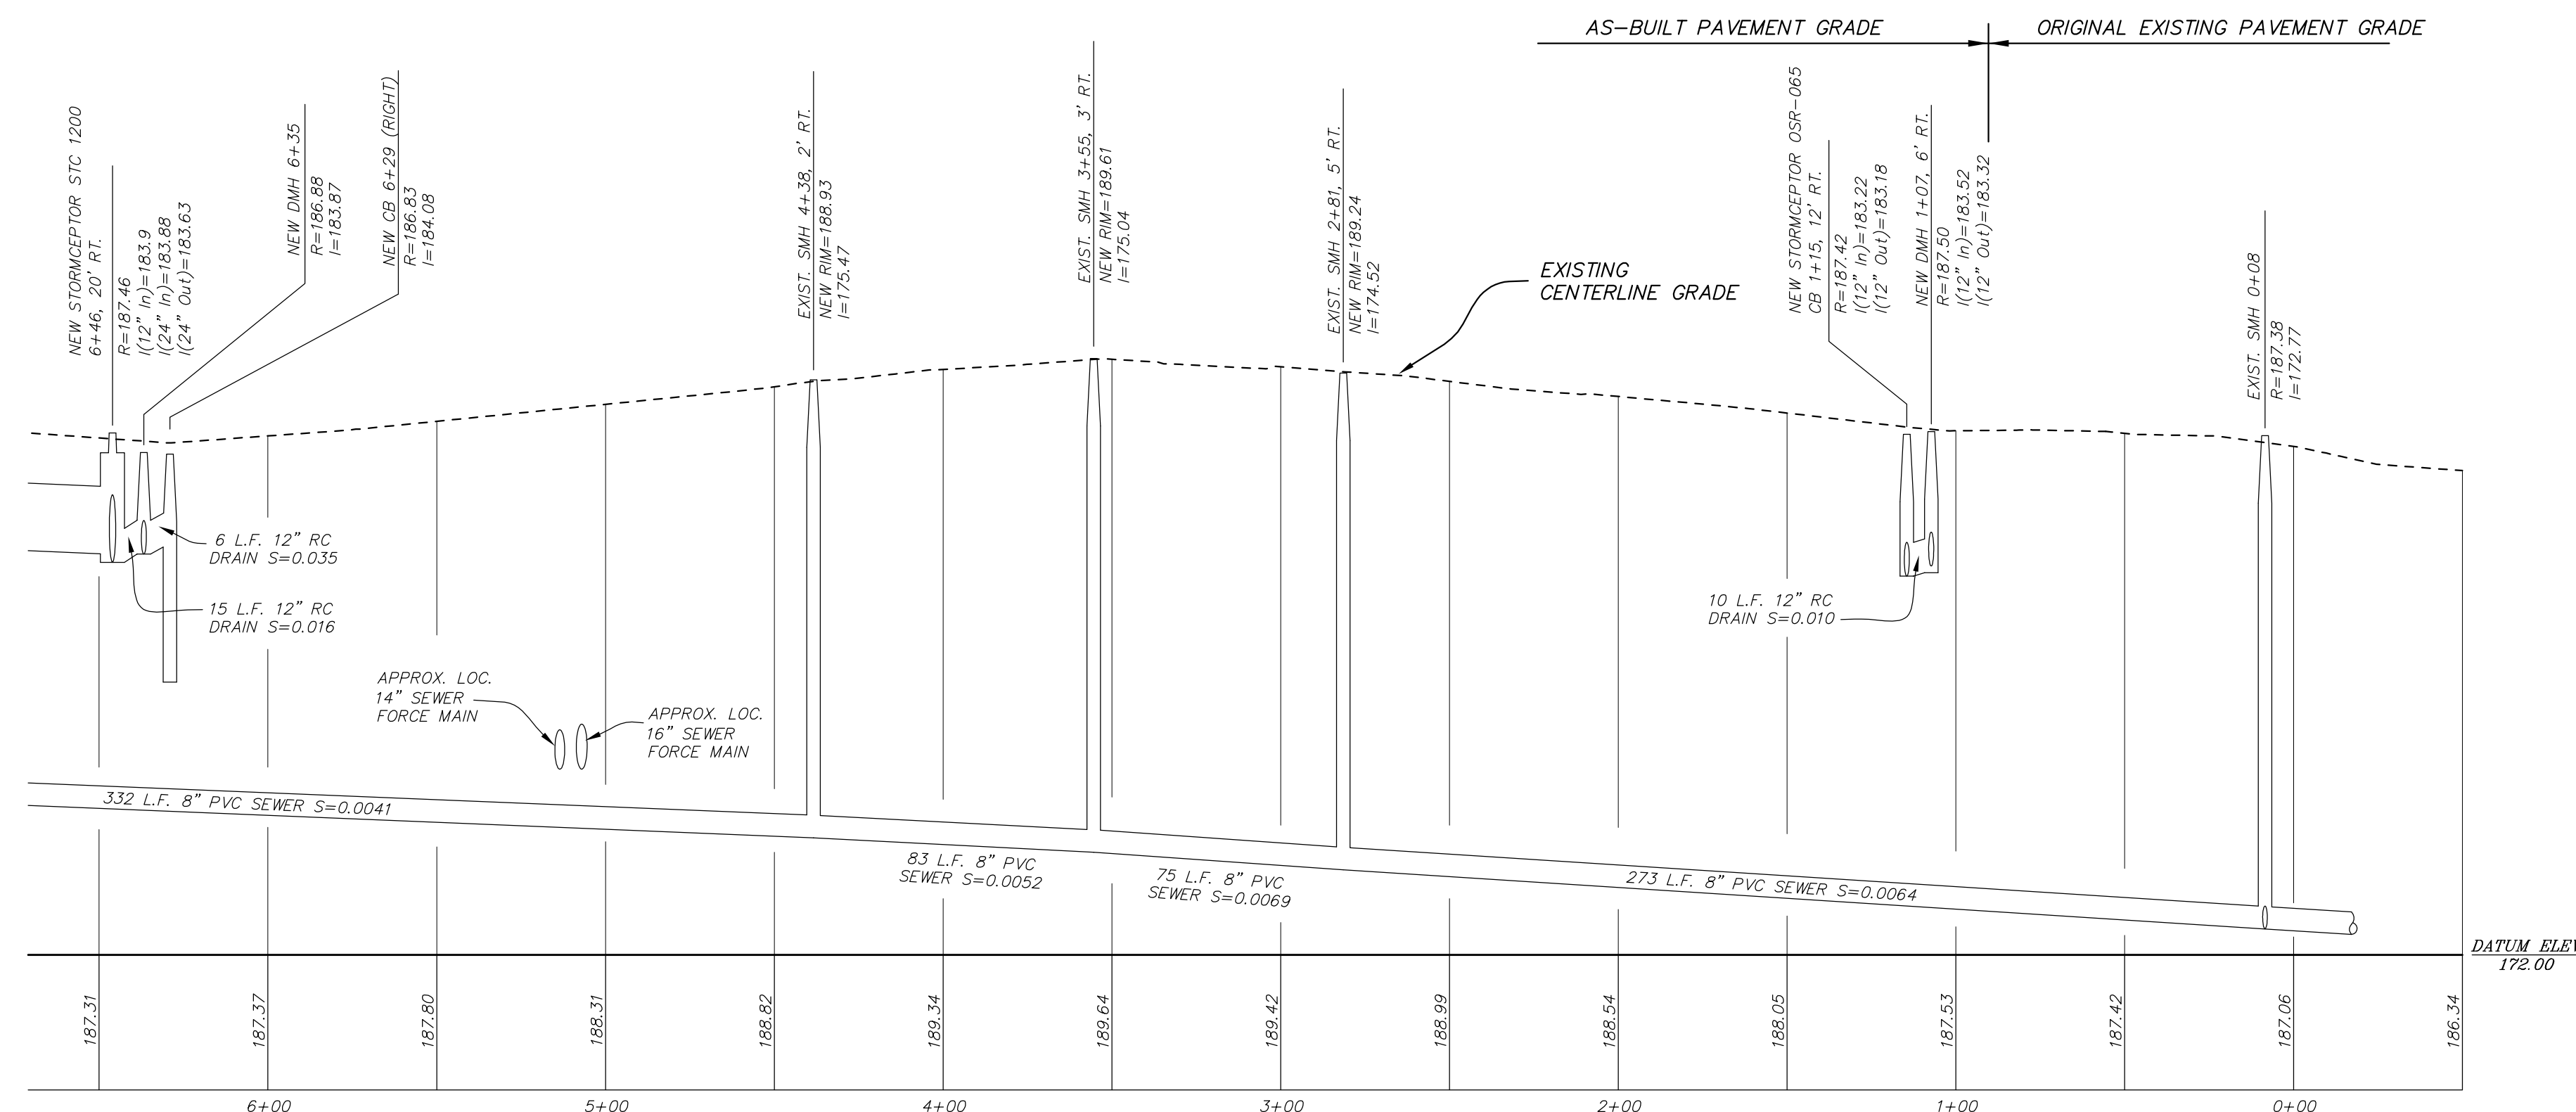

PROFILE
 SCALE: 1"=40' HORIZ.
 1"=4' VERT.

LEGEND

- DMH DRAIN MANHOLE
- CB CATCH BASINS
- STC STORMCEPTOR
- SMH SEWER MANHOLE
- EMH ELECTRIC MANHOLE
- TMH TELEPHONE MANHOLE
- GG GAS GATE VALVE
- GS GAS SERVICE VALVE
- WG WATER GATE VALVE
- WS WATER SERVICE VALVE
- HYD HYDRANT
- LP LIGHT POLE
- U.P. UTILITY POLE
- U.P./LP UTILITY POLE w/ LIGHT
- VGC VERTICAL GRANITE CURB
- CCB CAPE COD BERM
- EP EDGE OF PAVEMENT
- CATV BOX CABLE TV BOX
- TELE. BOX TELEPHONE BOX
- ELEC. BOX ELECTRIC BOX
- RIP RAP RIP RAP
- DH DRILL HOLE
- SB/DH STONE BOUND w/ DRILL HOLE

I CERTIFY THAT THIS PLAN HAS BEEN PREPARED IN CONFORMITY WITH THE RULES AND REGULATIONS OF THE REGISTERS OF DEEDS OF THE COMMONWEALTH OF MASSACHUSETTS.

DATE: _____


REGISTERED LAND SURVEYOR

LAND SURVEYOR:
BORDERLAND ENGINEERING, INC.
615 PLEASANT STREET
RANDOLPH, MA 02368

I CERTIFY THAT THIS PLAN SHOWS THE PROPERTY LINES THAT ARE THE LINES OF EXISTING OWNERSHIPS, AND THE LINES OF STREETS AND WAYS SHOWN ARE THOSE OF PUBLIC OR PRIVATE STREETS OR WAYS ALREADY ESTABLISHED, AND THAT NO NEW LINES FOR DIVISION OF EXISTING OWNERSHIP OR FOR NEW WAYS ARE SHOWN.

DATE: _____

REGISTERED LAND SURVEYOR

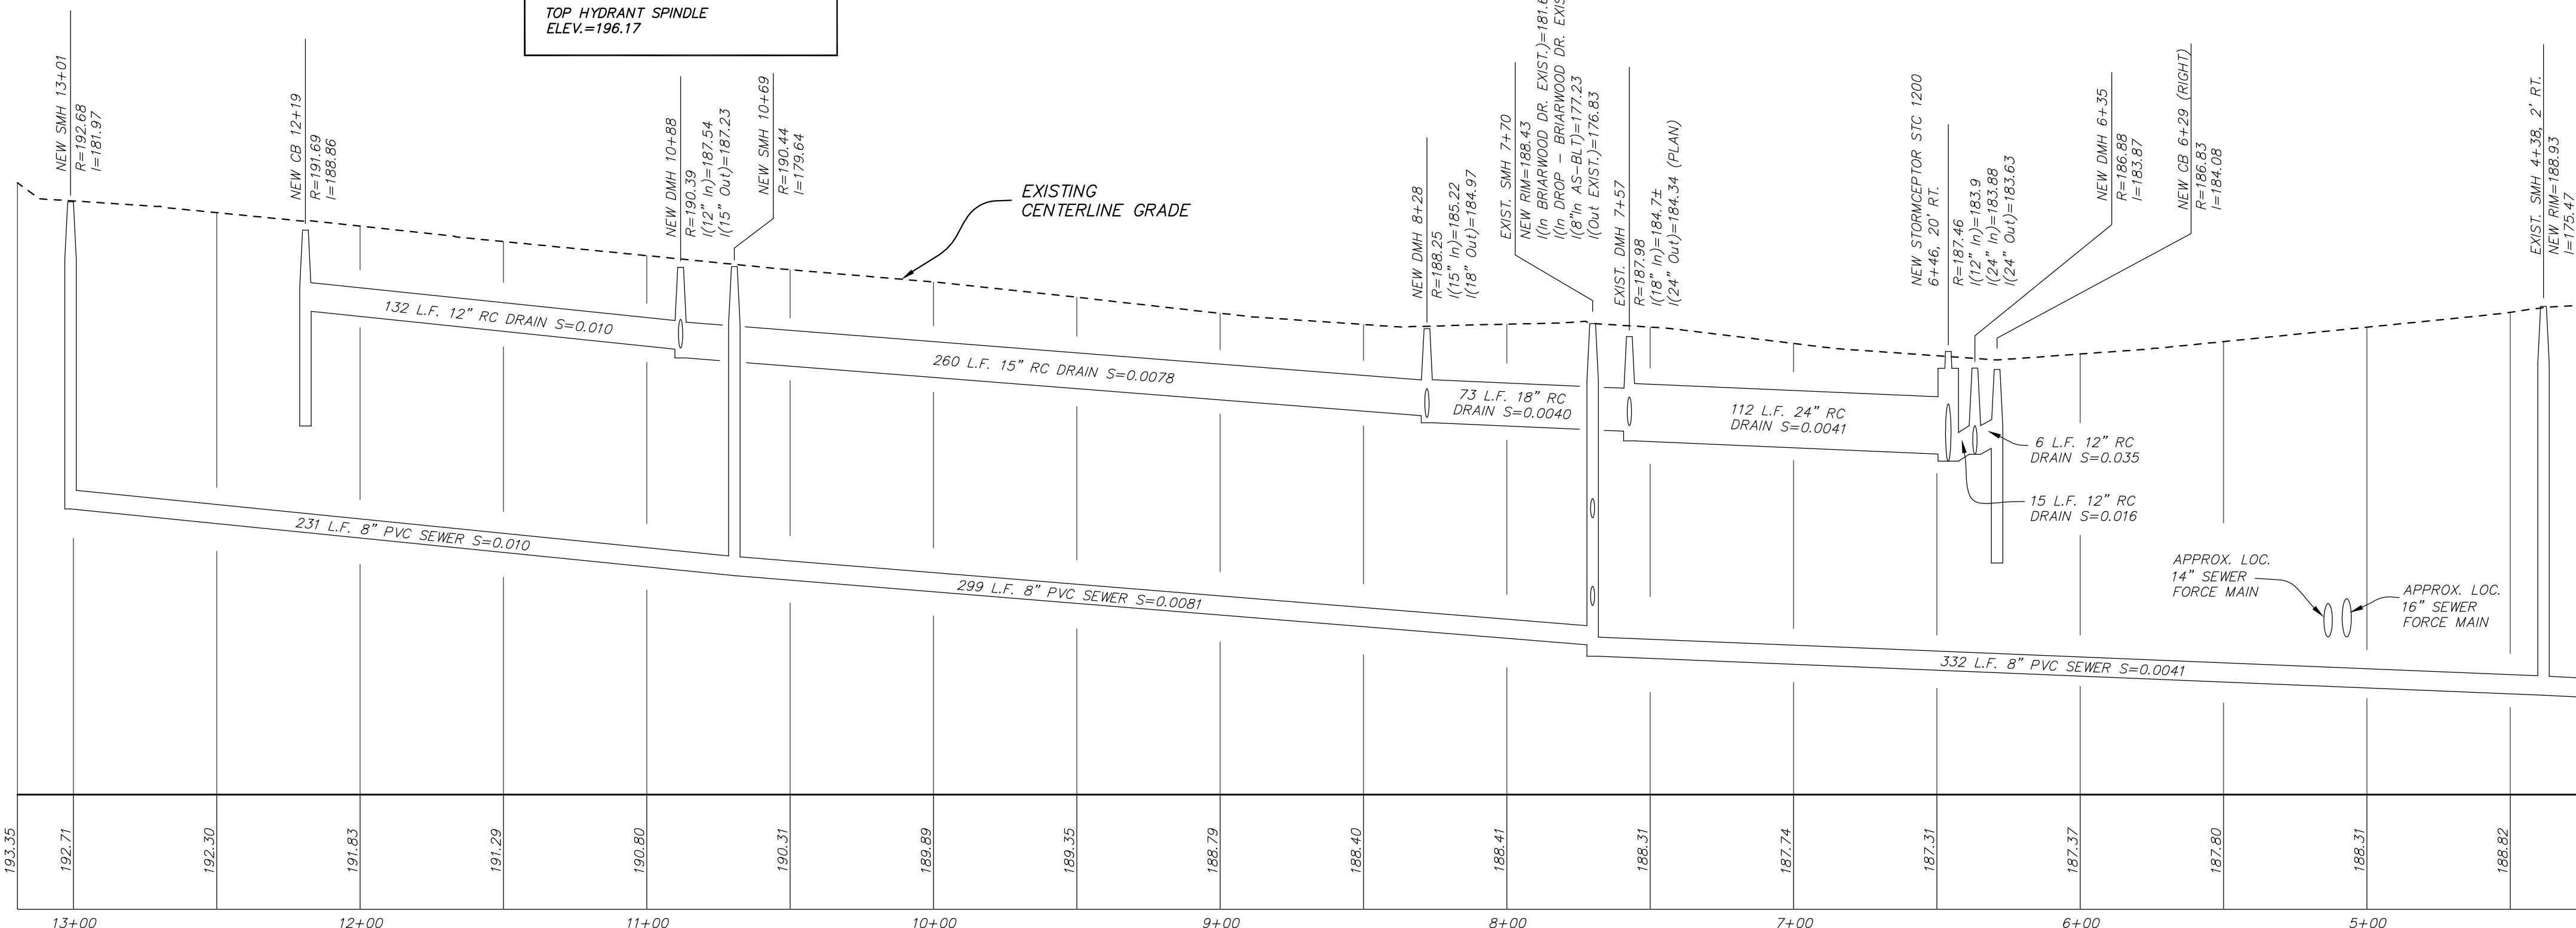

PROFILE
SCALE: 1"=40' HORIZ.
1"=4' VERT.

PLAN VIEW
SCALE: 1"=40'

- PLAN NOTES:**
- AS-BUILT INFORMATION WAS A RESULT OF A FIELD SURVEY BY BORDERLAND ENGINEERING, INC. IN AUGUST, 2017.
 - BURIED UTILITY LOCATIONS ARE APPROXIMATE ONLY. FIELD VERIFY ALL UTILITIES PRIOR TO DEMOLITION/CONSTRUCTION. CALL DIG-SAFE AT 1-888-DIG-SAFE.

- PROJECT BENCHMARK No. 1:**
TOP HYDRANT SPINDLE
ELEV.=190.10
- PROJECT BENCHMARK No. 2:**
TOP HYDRANT SPINDLE
ELEV.=191.26
- PROJECT BENCHMARK No. 3:**
TOP HYDRANT SPINDLE
ELEV.=196.17

- LEGEND**
- DMH DRAIN MANHOLE
 - CB CATCH BASIN
 - STC STORMCEPTOR
 - SMH SEWER MANHOLE
 - EMH ELECTRIC MANHOLE
 - TMH TELEPHONE MANHOLE
 - GG GAS GATE VALVE
 - GS GAS SERVICE VALVE
 - WG WATER GATE VALVE
 - WS WATER SERVICE VALVE
 - HYD HYDRANT
 - LP LIGHT POLE
 - U.P. UTILITY POLE
 - U.P./LP UTILITY POLE w/ LIGHT
 - VGC VERTICAL GRANITE CURB
 - CCB CAPE COD BERM
 - EP EDGE OF PAVEMENT
 - CATV BOX CABLE TV BOX
 - TELE. BOX TELEPHONE BOX
 - ELEC. BOX ELECTRIC BOX
 - RIP RAP RIP RAP
 - DH DRILL HOLE
 - SB/DH STONE BOUND w/ DRILL HOLE

DRAINAGE OUTLET PROFILE No. 2
SCALE: 1"=40' HORIZ.
1"=4' VERT.

DATE APPROVED: _____

PLANNING BOARD – TOWN OF WESTWOOD

DATE APPROVED: _____

BOARD OF SELECTMAN – TOWN OF WESTWOOD

RECEIVED AND FILED: _____

WESTWOOD TOWN CLERK

STREET ACCEPTANCE & AS-BUILT PLAN
THOMPSON AVENUE
IN
WESTWOOD, MA
SCALE: AS SHOWN AUG. 30, 2017
Site Design Professionals, LLC

Civil Engineers
One Merchant Street - Suite 110
Sharon, MA 02067
Tel. 781-784-4020 - Fax 781-784-4022

REVISIONS
0C.T. 13, 2017



Z:\ENGINEERING\SDP\PROJ\18-00127 THOMPSON AVE-RESTWOOD.dwg 18-00127-C-0093-01-STREET-ASBLT.dwg